

CONSTRUCTION DRAWINGS
Prepared For

INDIAN RIVER INLET
MSE WALLS

SUBMITTAL NO. 002553-001 (R2)
SPECIFICATION SECTION NO. 602553, 557, 670-673
SPEC. SECTION DESCRIPTION MSE Walls 1, 2, 3, 5, 6, 7
SUBMITTAL DESCRIPTION MSE Wall Const. DWG's

WE CERTIFY THAT THIS SUBMITTAL HAS
BEEN REVIEWED, CHECKED AND APPROVED
AND IS IN CONFORMANCE WITH THE REQUIREMENTS
OF THE CONTRACT DOCUMENTS

SIGNED *Julie Kuhn* **KUHN**
DATE 2/9/06 CONSTRUCTION

SHOP DRAWING REVIEW	
<input type="checkbox"/> FOR INFORMATION ONLY	<input checked="" type="checkbox"/> ACCEPTED AS NOTED & RESUBMIT
<input checked="" type="checkbox"/> ACCEPTED	<input type="checkbox"/> NOT ACCEPTED
<small>This review is only for general conformance with design intent of the project and general compliance with the information given in the contract documents. Review, corrections or comments made concerning the shop drawings during this review do not relieve the contractor from compliance with requirements of the drawings and specifications, nor relieve the contractor of contractual responsibility for any error or deviation from contract requirements. The contractor is responsible for confirming and correlating all quantities, dimensions and structural capabilities - Scheduling fabrication processes and techniques of construction - Coordinating his work with that of all other trades - and performing his work in a safe and satisfactory manner.</small>	
FIGG Subconsultant Firm: <i>RK&K Engineers</i> By: <i>SK</i> Date: <i>2/8/06</i> FIGG BRIDGE ENGINEERS, INC. By: <i>N.D. Pett</i> Date: <i>3/9/06</i> For Delaware Department of Transportation	



SUSSEX COUNTY,

DELAWARE

INDEX

SHEET

- 1.
- 2.
DESCRIPTION

- Title Sheet
- Construction Requirements
- Plan View
- Elevation View - Wall 1
- Elevation View - Wall 1 (Cont.)
- Elevation View - Wall 2
- Elevation View - Wall 2 (Cont.)
- Elevation View - Wall 2 (Cont.)
- Elevation View - Wall 3
- Elevation View - Wall 5
- Elevation View - Wall 6
- Elevation View - Wall 7
- Elevation View - Wall 7 (Cont.)

INDEX

SHEET

- 17.
- 18.
- 19.
- 20.
- 21.
- 22.
- 23.
- 24.
- 25.
- 26.
- 27.
- 28.


DESCRIPTION

- Elevation View - Wall 7 (Cont.)
- Elevation View - Wall 7 (Cont.)
- Elevation View - Wall 7 (Cont.)
- Elevation View - North Abutment MSE Wall
- Elevation View - South Abutment MSE Wall
- Typical Cross-Section - Walls 1 & 7 and Walls 2 & 6
- Typical Cross-Section - Wall 3
- Typical Cross-Section - Wall 5
- Typical Cross-Section - Abutment MSE Wall
- Typical Details
- Typical Details
- Typical Details

JH
2/3/06

THIS DESIGN IS BASED UPON SPECIFIC PROPERTIES OF TENSAR PRODUCTS (GEOGRIDS, DRAINAGE COMPOSITES AND EROSION MEDIA), WHICH ARE PROPRIETARY TO THE TENSAR CORPORATION 1210 CITIZENS PARKWAY, MORROW GA. 30260. ANY SUBSTITUTION OF THE SPECIFIED PRODUCTS WILL INVALIDATE THIS DESIGN. THIS DRAWING IS BEING FURNISHED FOR USE ON THIS SPECIFIC PROJECT ONLY. ANY PARTY ACCEPTING THIS DOCUMENT DOES SO IN CONFIDENCE AND AGREES THAT IT SHALL NOT BE DUPLICATED WHOLE OR IN PART, NOR DISCLOSED TO OTHERS, WITHOUT THE CONSENT OF TENSAR EARTH TECHNOLOGIES, INC.

COPYRIGHT 2005, TENSAR EARTH TECHNOLOGIES, INC.

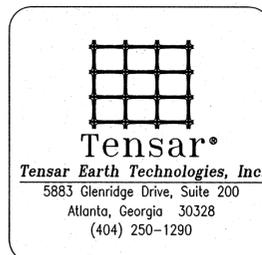

REVISIONS \ ISSUE		
1	12/15/04	WALL GEOMETRY REVISIONS
2	1/26/05	REVISION OF HIGH WATER ELEVATION AND WALL GEOMETRY
3	2/10/05	ADDENDUM No. 1
4	8/12/05	ISSUED FOR REVIEW - FINAL DESIGN
5	8/9/05	REVISED ABUTMENT MSE WALL
6	10/31/05	REVISIONS AS REQUIRED BY RK&K
△	2/8/06	ISSUED FOR CONSTRUCTION

Project Number N04513
File Name N0451301.DWG
Date Drawn 9/28/04
Scale As Shown
Designed by CV/WL
Drawn by JMR
Checked by

INDIAN RIVER INLET
MSE WALLS

SUSSEX COUNTY, DELAWARE

TITLE SHEET

Sheet Number
1 of 28