

NOTE:
 THE LOCATION OF ALL UNDERGROUND UTILITIES AND FEATURES SHOWN ARE APPROXIMATE ONLY AND NO GUARANTEE IS MADE THAT ALL EXISTING UTILITIES ARE SHOWN ON THE PLAN. THE CONTRACTOR SHALL FIELD VERIFY BOTH HORIZONTAL AND VERTICAL LOCATIONS OF ALL EXISTING UTILITIES PRIOR TO BEGINNING ANY CONSTRUCTION AT NO ADDITIONAL COST. THE CONTRACTOR SHALL CONTACT MISS UTILITY (1-800-282-8555) PRIOR TO THE BEGINNING OF ANY CONSTRUCTION ACTIVITY.

1:34-5.00-2.00
 STATE OF DELAWARE
 D.O. 1857-073
 FORMERLY:
 STATE OF DELAWARE PUBLIC LANDS
 KNOWN AS PARCEL NO. 11-6

1:34-5.00-3.00
 STATE OF DELAWARE
 D.O. 1857-073
 FORMERLY:
 STATE OF DELAWARE PUBLIC LANDS
 KNOWN AS PARCEL NO. 12-9

CONTROL COORDINATES

DESCRIPTION	STATION	NORTH	EAST
AIR RELEASE MH 2	340+39.75	219718.9821 219715.76	757228.7716 757227.79

- LEGEND**
- STABILIZED CONSTRUCTION ENTRANCE
 - PAVING PATCH
 - PERMANENT EASEMENT
 - RSF— REINFORCED SILT FENCE
 - ⊗— TEMPORARY CHAIN LINK FENCE


MATCH LINE SEE PLAN 02

MATCH LINE SEE PLAN 04



DATE:	DESCRIPTION:	BY:
7-14-05	AS-BUILT INFORMATION	RK&K

**DELAWARE SEASHORE STATE PARK
 INDIAN RIVER MARINA RE-DEVELOPMENT
 PHASE II SANITARY SEWER PLANS**

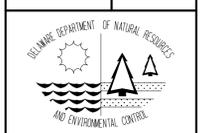

DESIGNED BY:	RK&K
DRAWN BY:	RK&K
BUILDING NO.:	N/A
DATE:	OCTOBER 15, 2004
SCALE:	1" = 50'
SHEET NO.:	PLAN 01
E. F. N.:	