


NOTE:

THE LOCATION OF ALL UNDERGROUND UTILITIES AND FEATURES SHOWN ARE APPROXIMATE ONLY AND NO GUARANTEE IS MADE THAT ALL EXISTING UTILITIES ARE SHOWN ON THE PLAN. THE CONTRACTOR SHALL FIELD VERIFY BOTH HORIZONTAL AND VERTICAL LOCATIONS OF ALL EXISTING UTILITIES PRIOR TO BEGINNING ANY CONSTRUCTION AT NO ADDITIONAL COST. THE CONTRACTOR SHALL CONTACT MISS UTILITY (1-800-282-8555) PRIOR TO THE BEGINNING OF ANY CONSTRUCTION ACTIVITY.



MATCH LINE SEE PLAN 01B

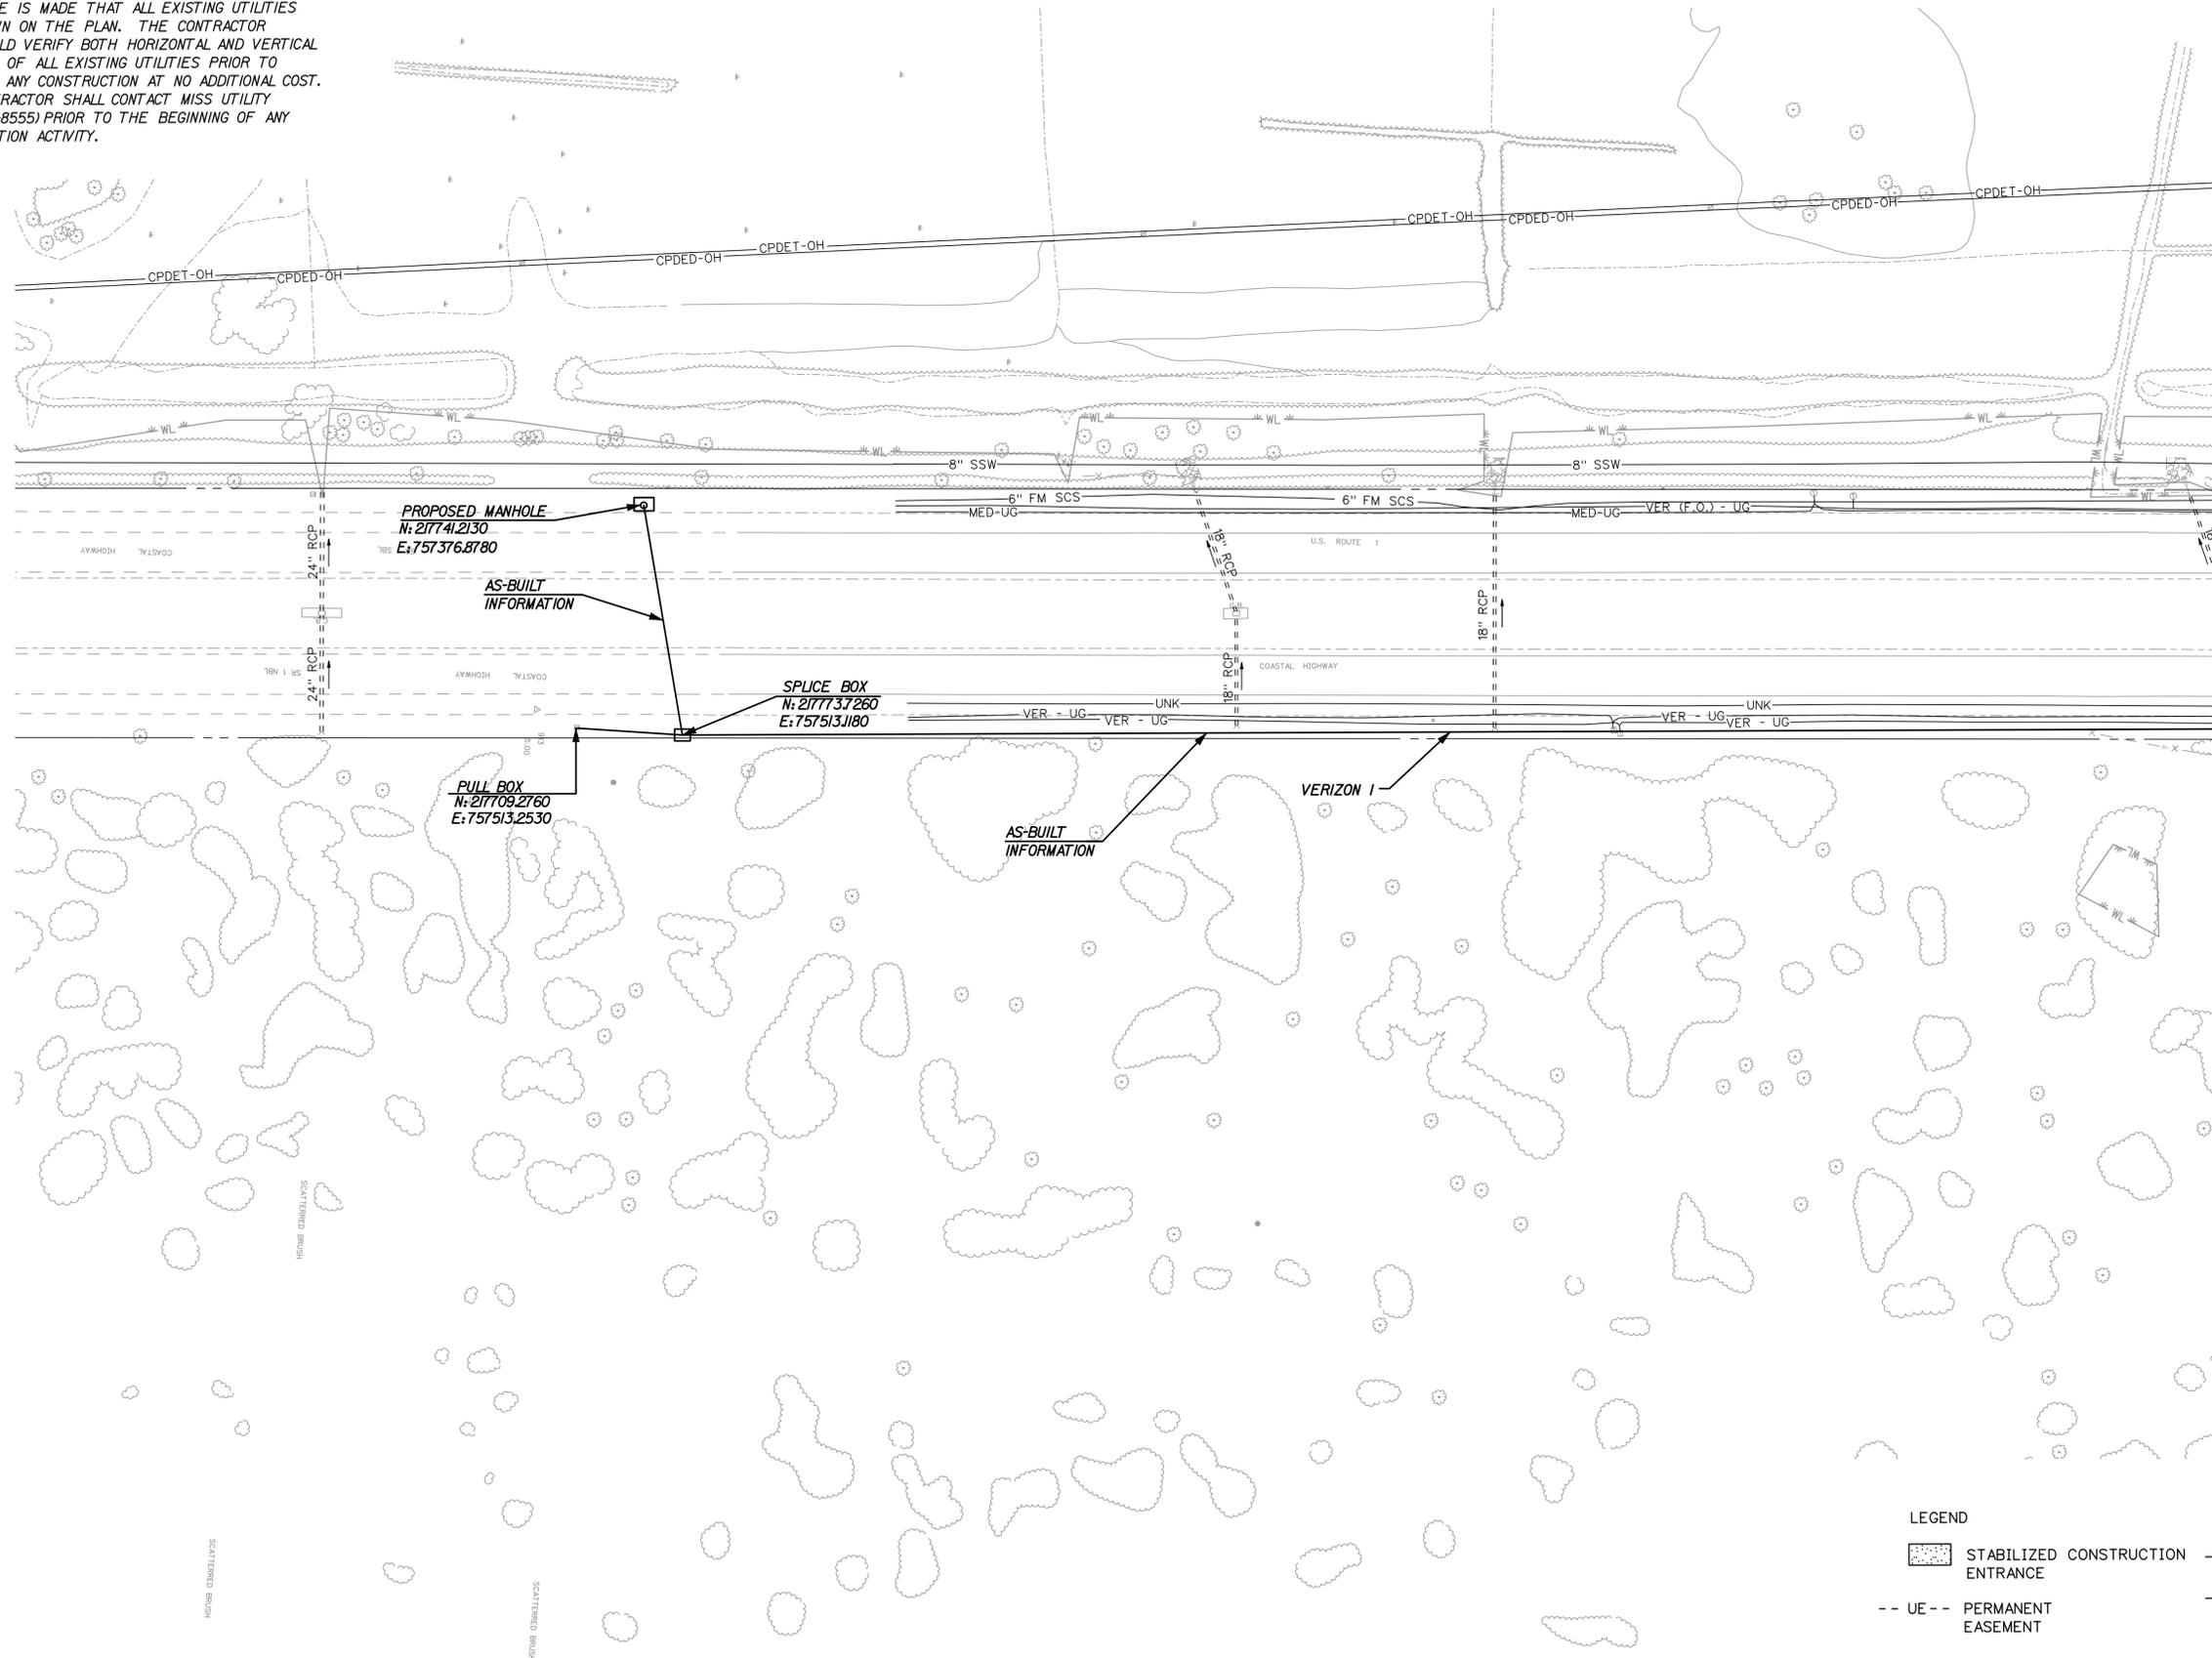

LEGEND

STABILIZED CONSTRUCTION ENTRANCE	—RSF— REINFORCED SILT FENCE
-- UE -- PERMANENT EASEMENT	⊗ — TEMPORARY CHAIN LINK FENCE
	PAVEMENT PATCH

DATE:	DESCRIPTION:	BY:
7-14-05	AS-BUILT INFORMATION	RK&K

**DELAWARE SEASHORE STATE PARK
INDIAN RIVER MARINA RE-DEVELOPMENT
PHASE II - VERIZON PLANS**

DESIGNED BY:	RK&K
DRAWN BY:	RK&K
BUILDING NO. :	N/A
DATE:	OCTOBER 28, 2004
SCALE:	1" = 50'
SHEET NO. :	PLAN 01A
E. F. N. :	