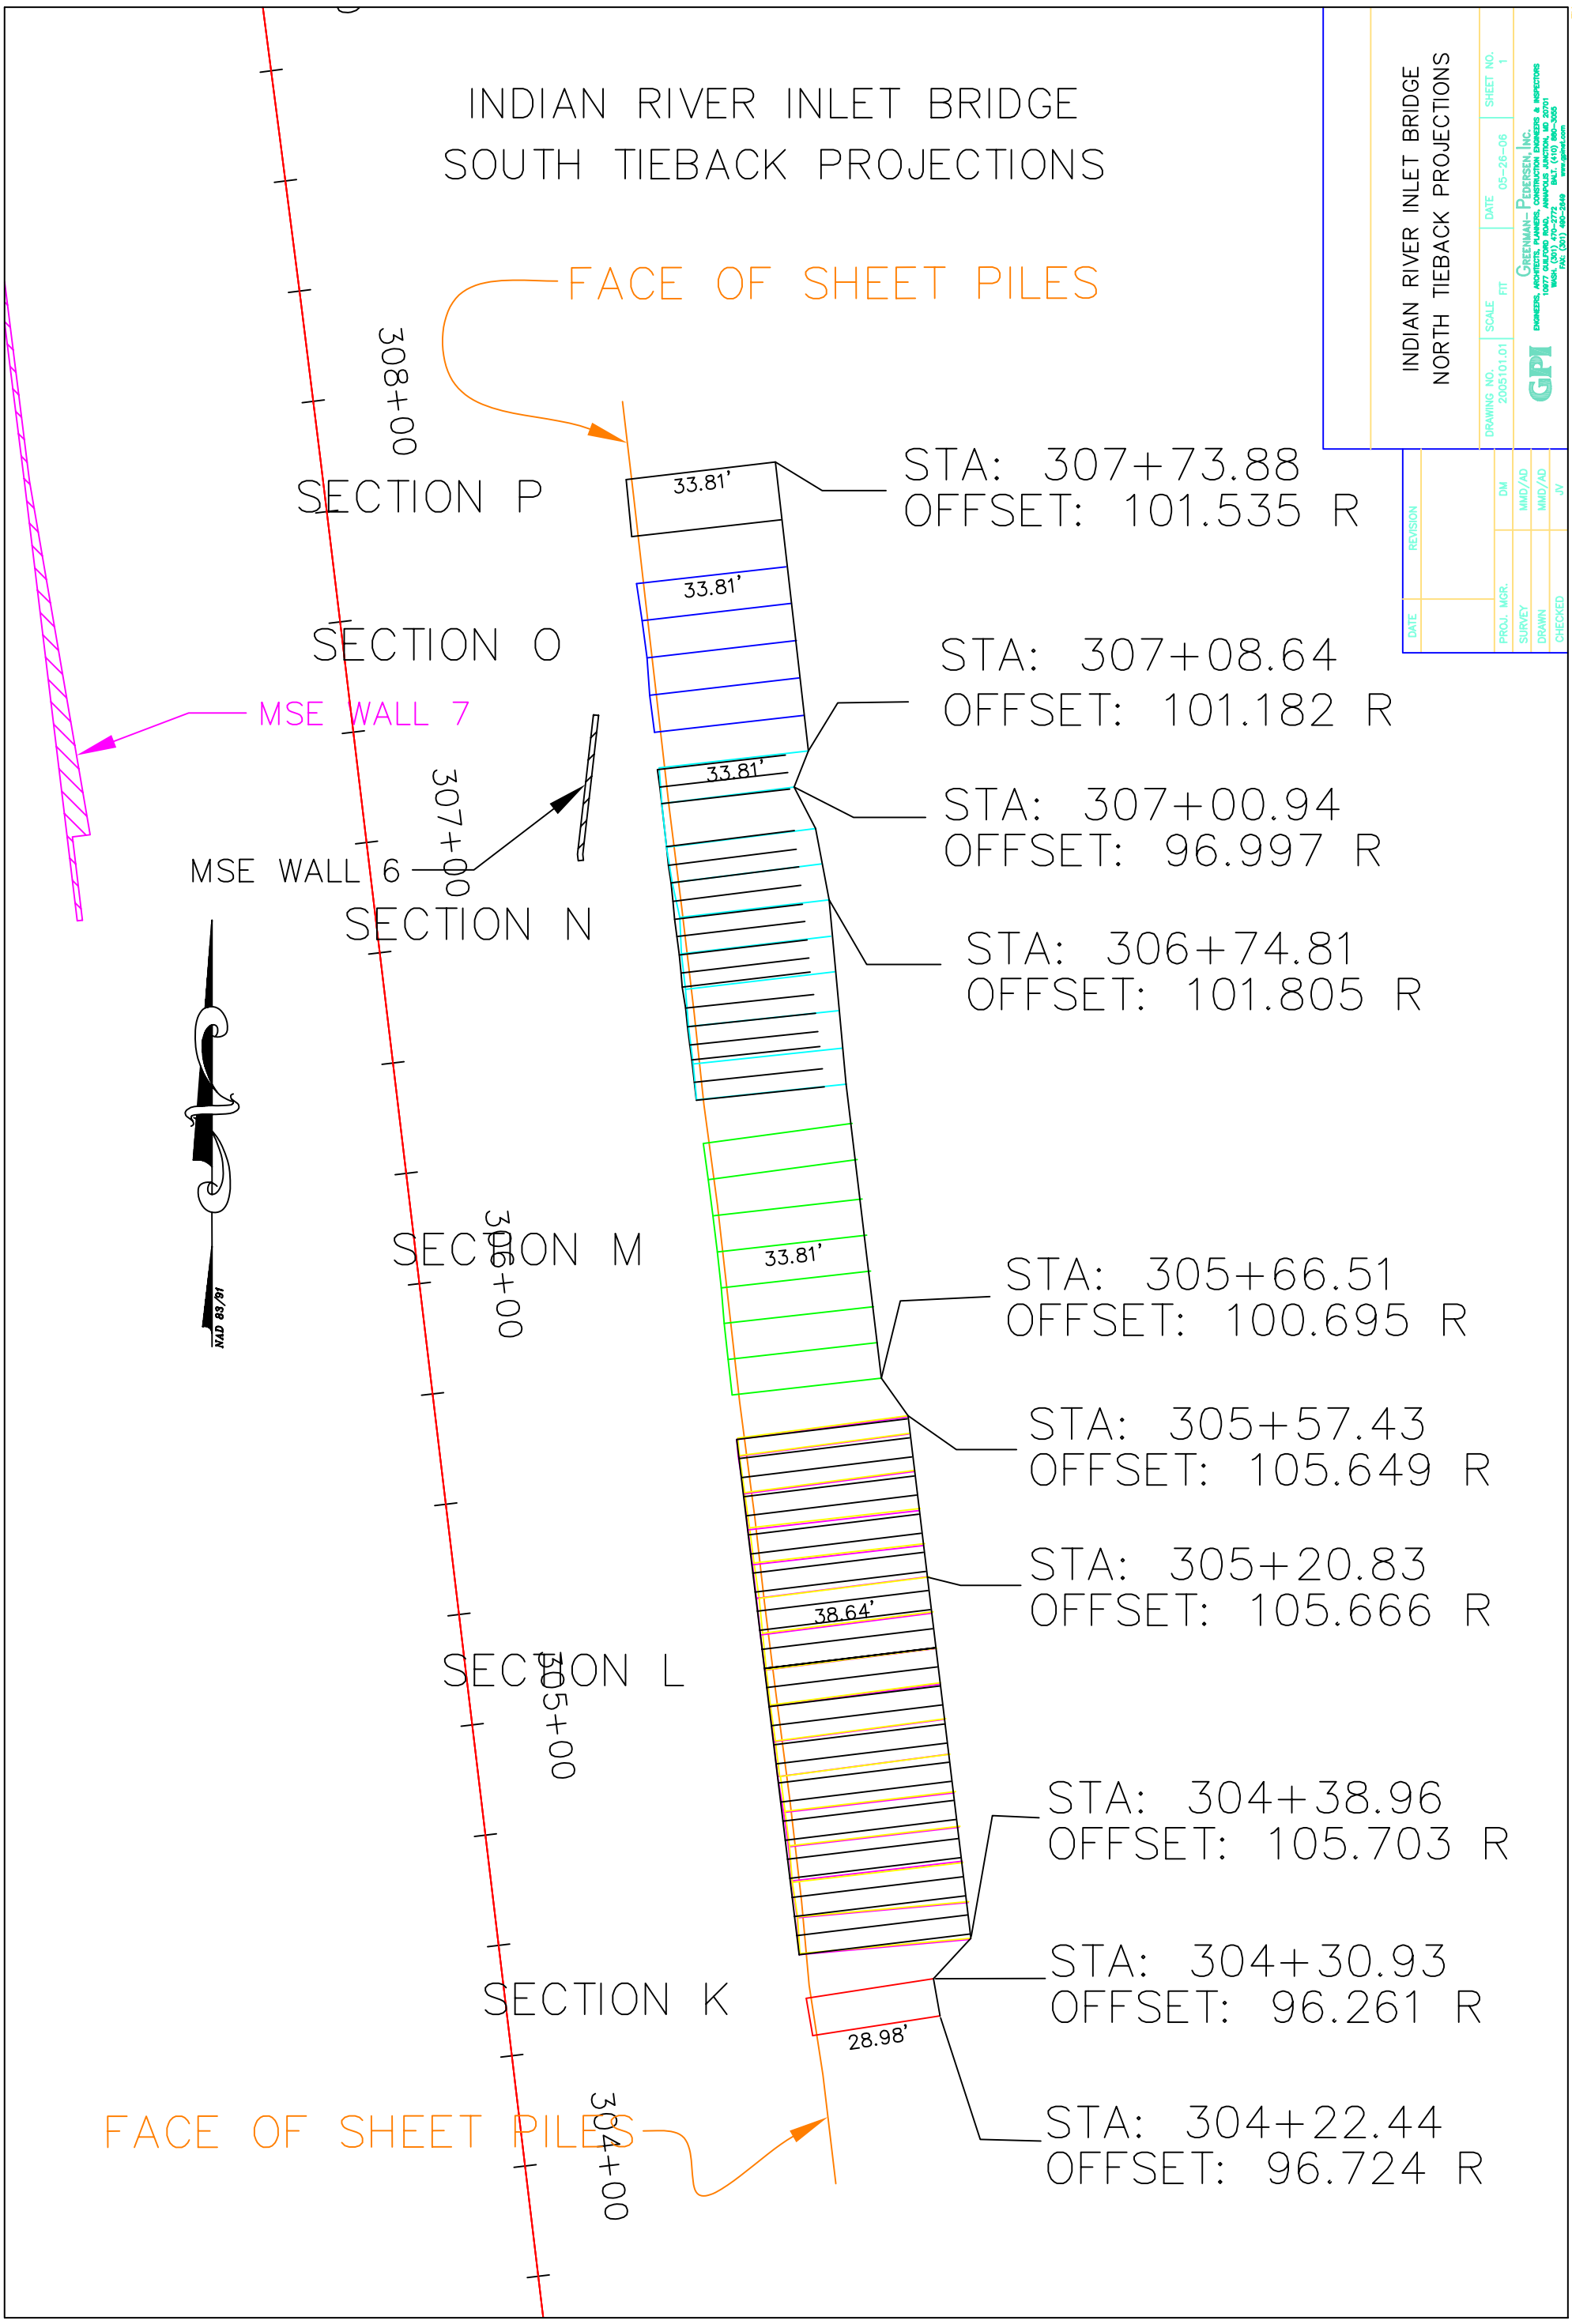
INDIAN RIVER INLET BRIDGE
SOUTH TIEBACK PROJECTIONS
FACE OF SHEET PILES
308+00
SECTION P
33.81'
STA: 307+73.88
OFFSET: 101.535 R
33.81'
SECTION O
STA: 307+08.64
OFFSET: 101.182 R
MSE WALL 7
33.81'
STA: 307+00.94
OFFSET: 96.997 R
307+00
MSE WALL 6
SECTION N
STA: 306+74.81
OFFSET: 101.805 R
NAD 83/91
SECTION M
306+00
33.81'
STA: 305+66.51
OFFSET: 100.695 R
STA: 305+57.43
OFFSET: 105.649 R
STA: 305+20.83
OFFSET: 105.666 R
38.64'
SECTION L
305+00
STA: 304+38.96
OFFSET: 105.703 R
STA: 304+30.93
OFFSET: 96.261 R
SECTION K
28.98'
FACE OF SHEET PILES
304+00
STA: 304+22.44
OFFSET: 96.724 R
INDIAN RIVER INLET BRIDGE
NORTH TIEBACK PROJECTIONS
DRAWING NO. 2005101.01
SCALE FIT
DATE 05-26-06
SHEET NO. 1
GPI
GREENMAN-PEDERSEN, INC.
ENGINEERS, ARCHITECTS, PLANNERS, CONSTRUCTION ENGINEERS & INSPECTORS
WASH. (301) 470-2772 BALT. (410) 880-0205
FAX: (301) 490-2649 www.gpinet.com
REVISION
DATE
PROJ. MGR. DM
SURVEY MMD/AD
DRAWN MMD/AD
CHECKED JV