VERIZON PROFILE

SCALE
0 50 100 HORIZ.
0 5 10 VERT.

NOTE:

1.SEE VERIZON PLAN FOR CONDUIT SIZE AND DETAILS

2.CONTRACTOR SHALL PROVIDE 12" MIN.CLEARANCE BETWEEN PROPOSED CONDUITS AND EXISTING OR PROPOSED UTILITIES.

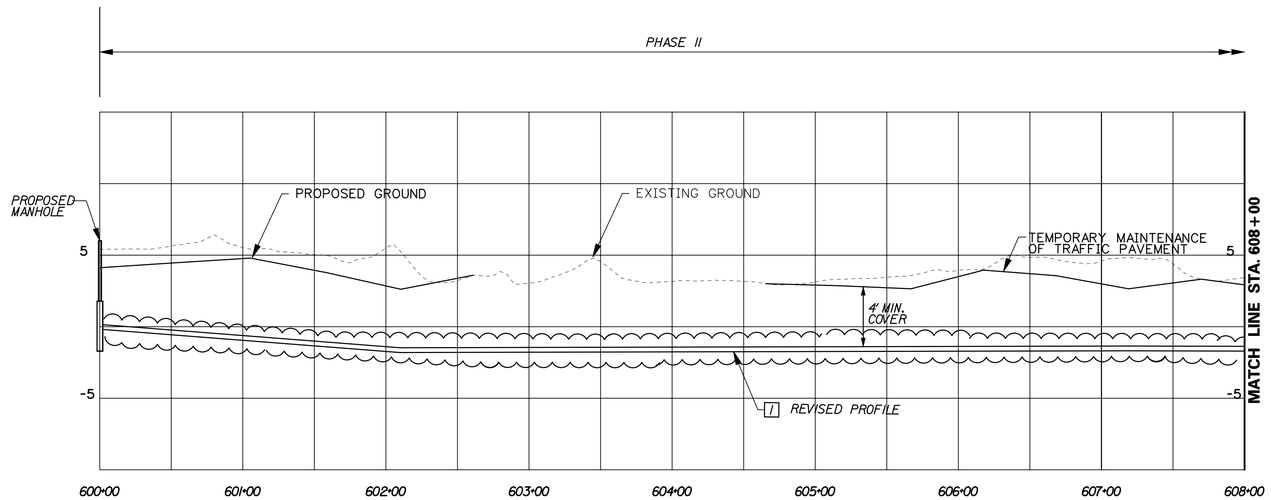

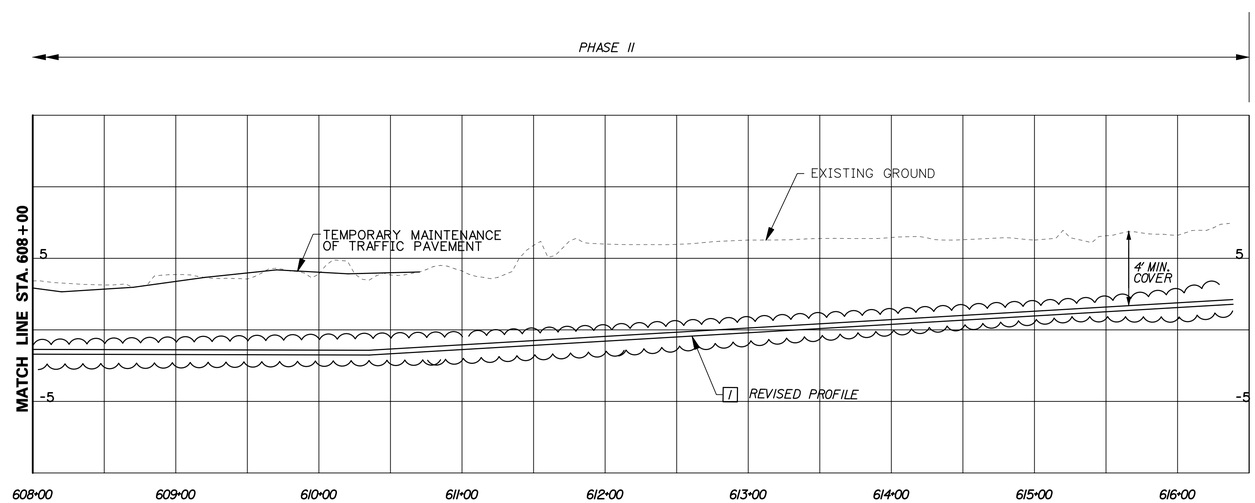

DATE:	DESCRIPTION:	BY:
1-19-05	7 REVISED PROFILE	RK&K

DELAWARE SEASHORE STATE PARK
INDIAN RIVER MARINA RE-DEVELOPMENT
PHASE II - VERIZON PLANS

DELAWARE DEPARTMENT OF NATURAL RESOURCES AND ENVIRONMENTAL CONTROL

DESIGNED BY: RK&K

DRAWN BY: RK&K

BUILDING NO.: N/A

DATE: OCTOBER 28, 2004

SCALE: 1" = 50'

SHEET NO.: PROFILE 03

E.F.N.:

k:\Projects\2003\IRB\DNREC\Dgn\Dnrec08V_IRB.dgn
9/21/2006
1:43:42 PM