WATER PROFILE 2
10" HDPE

SCALE
0 50 100 HORIZ.
0 5 10 VERT.

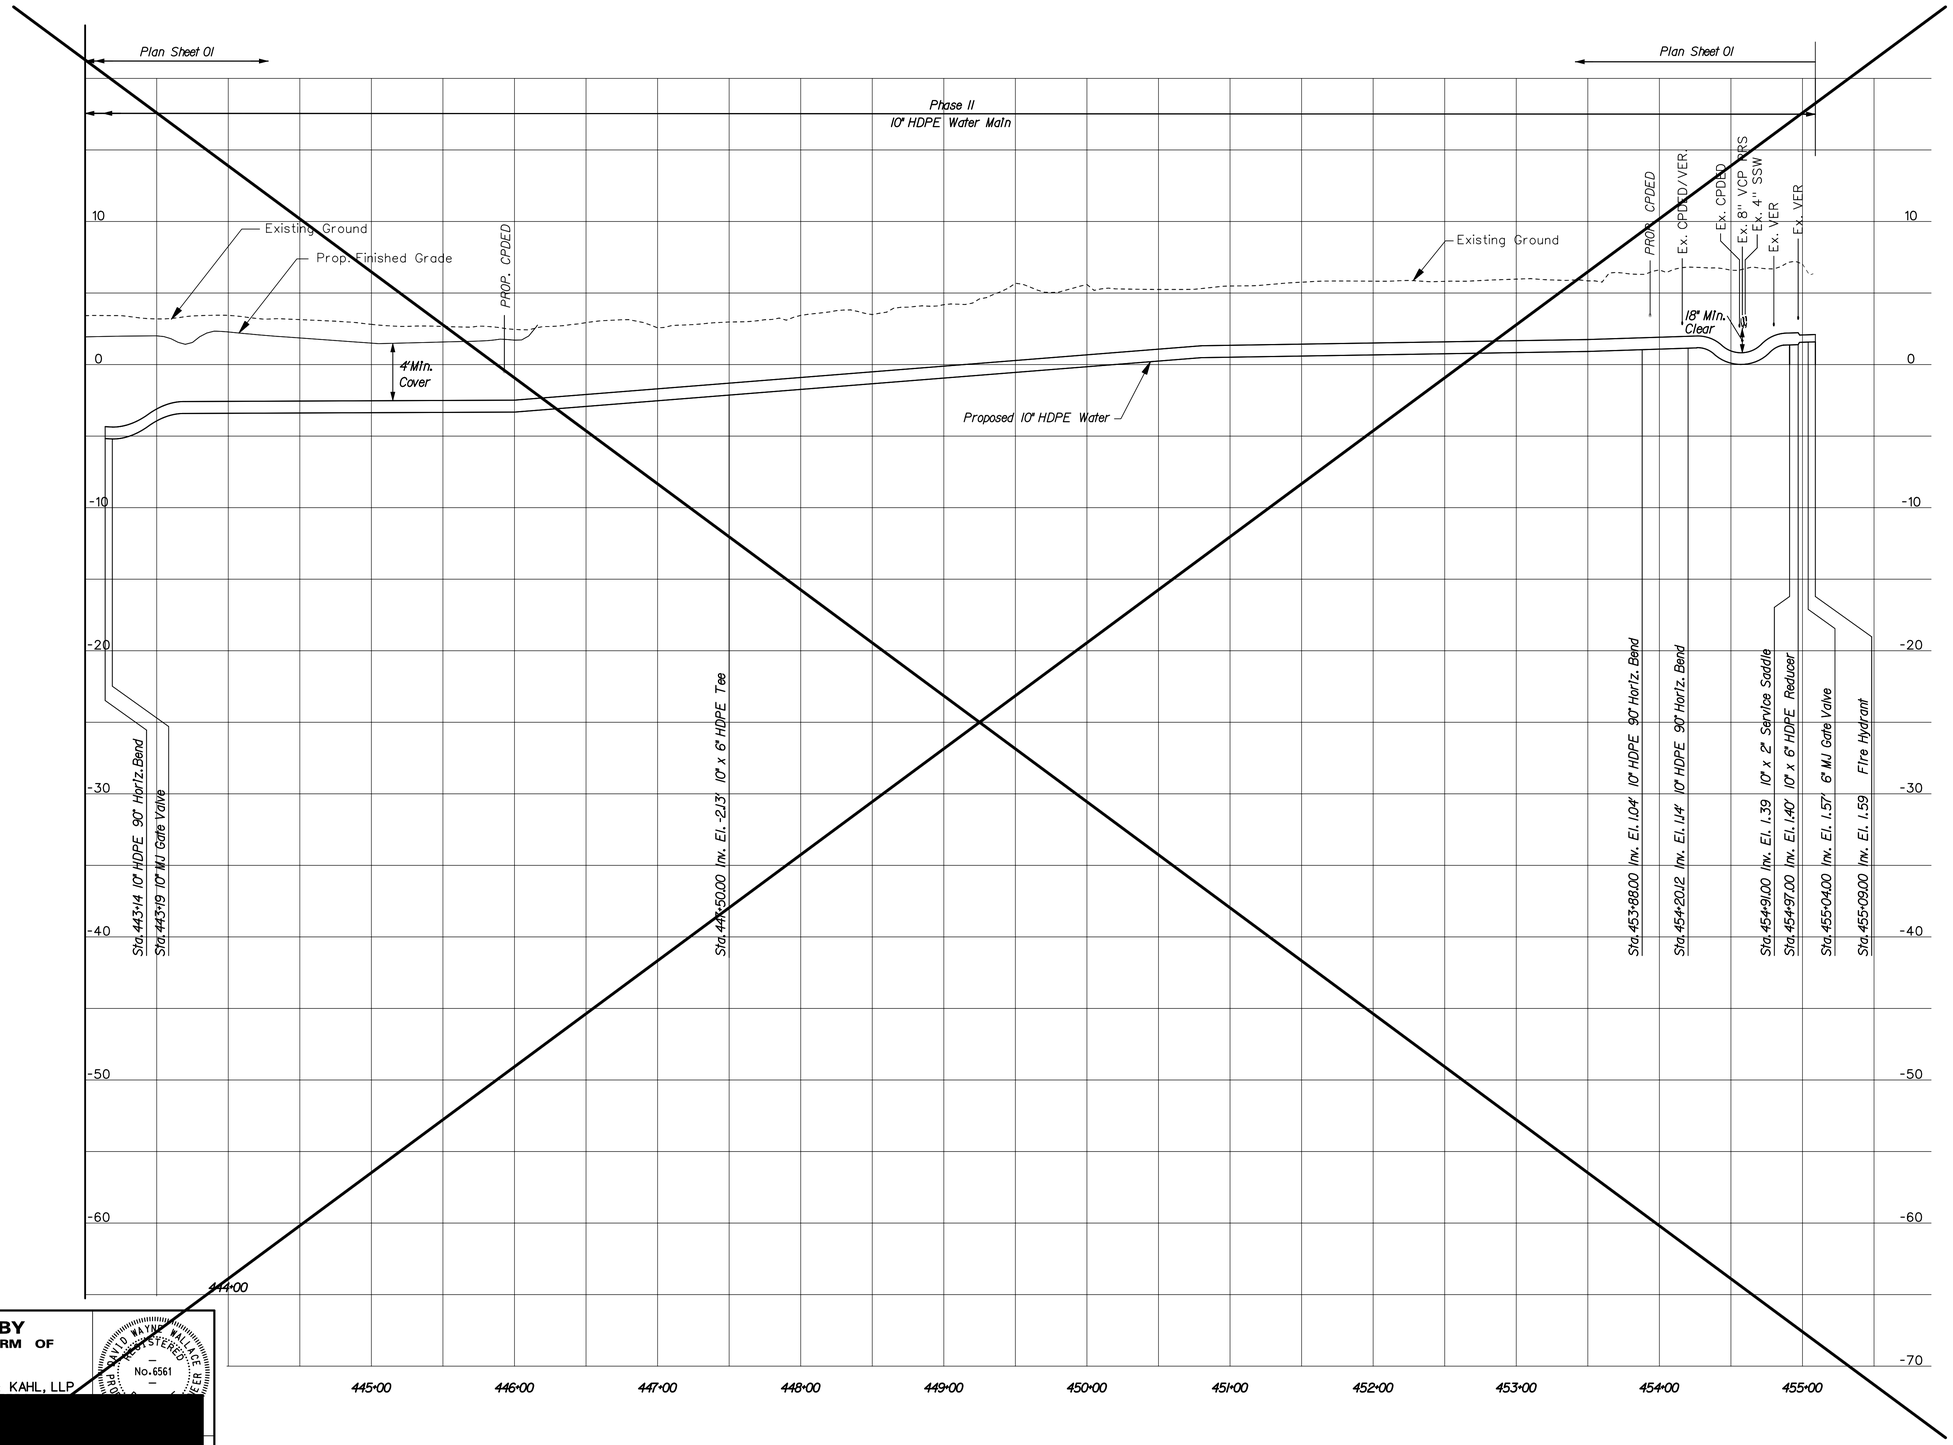

PREPARED BY
THE CONSULTING FIRM OF
RUMMEL, KLEPPER & KAHL, LLP

DAVID WAYNE WALLACE
REGISTERED
No. 6561
PROFESSIONAL ENGINEER

1.14.2005

9/21/2006
2:38:27 PM

DATE:	DESCRIPTION:	BY:
1-25-05	1 REVISED ALIGNMENT, THIS SHEET DELETED	RK&K

DELAWARE SEASHORE STATE PARK
INDIAN RIVER MARINA RE-DEVELOPMENT
PHASE II – WATER MAIN

DELAWARE DEPARTMENT OF NATURAL RESOURCES AND ENVIRONMENTAL CONTROL

DESIGNED BY: RK&K
DRAWN BY: RK&K
BUILDING NO.: N/A
DATE: OCTOBER 15, 2004
SCALE: 1" = 50'
SHEET NO.: PROFILE 04
E.F.N.: