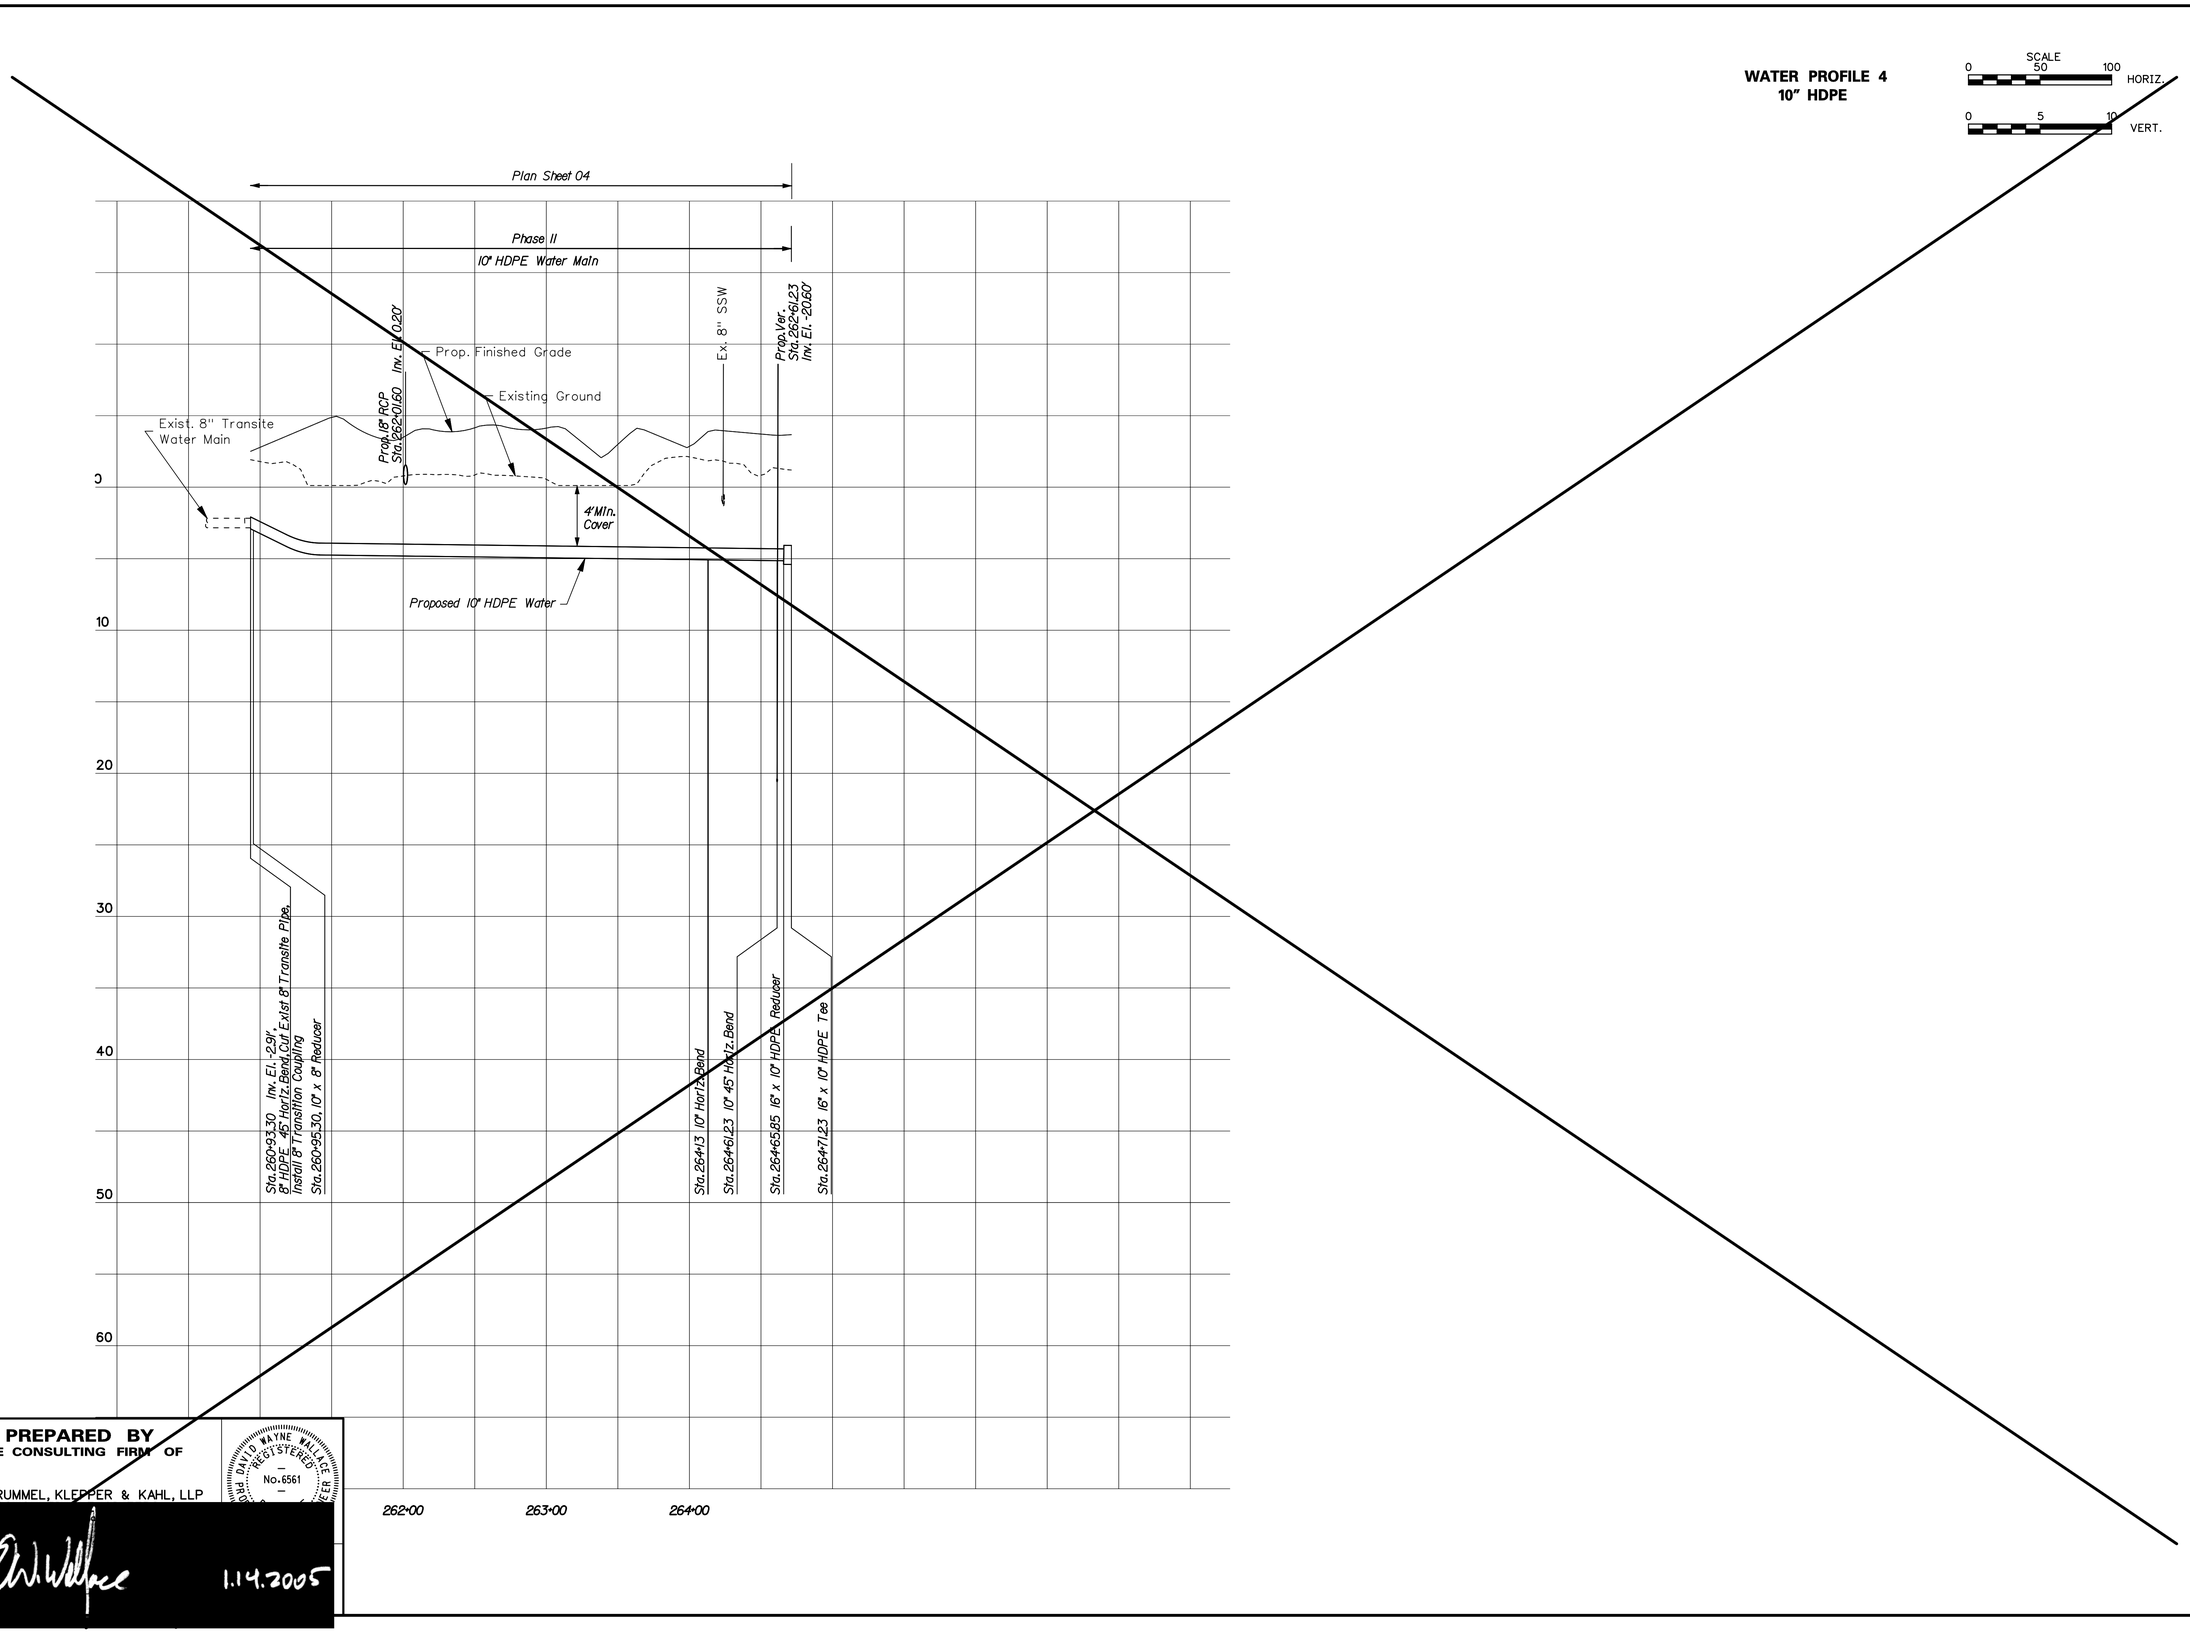

PREPARED BY
THE CONSULTING FIRM OF
RK RUMMEL, KLEPPER & KAHL, LLP

DAVID WAYNE WALLACE REGISTERED No. 6561

1.14.2005

9/21/2006
2:39:02 PM

DATE:	DESCRIPTION:	BY:
1-25-05	7 REVISED ALIGNMENT. THIS SHEET DELETED	RK&K

DELAWARE SEASHORE STATE PARK
INDIAN RIVER MARINA RE-DEVELOPMENT
PHASE II – WATER MAIN

DELAWARE DEPARTMENT OF NATURAL RESOURCES AND ENVIRONMENTAL CONTROL

DESIGNED BY: RK&K
DRAWN BY: RK&K
BUILDING NO.: N/A
DATE: OCTOBER 15, 2004
SCALE: 1" = 50'
SHEET NO.: PROFILE 06
E.F.N.: