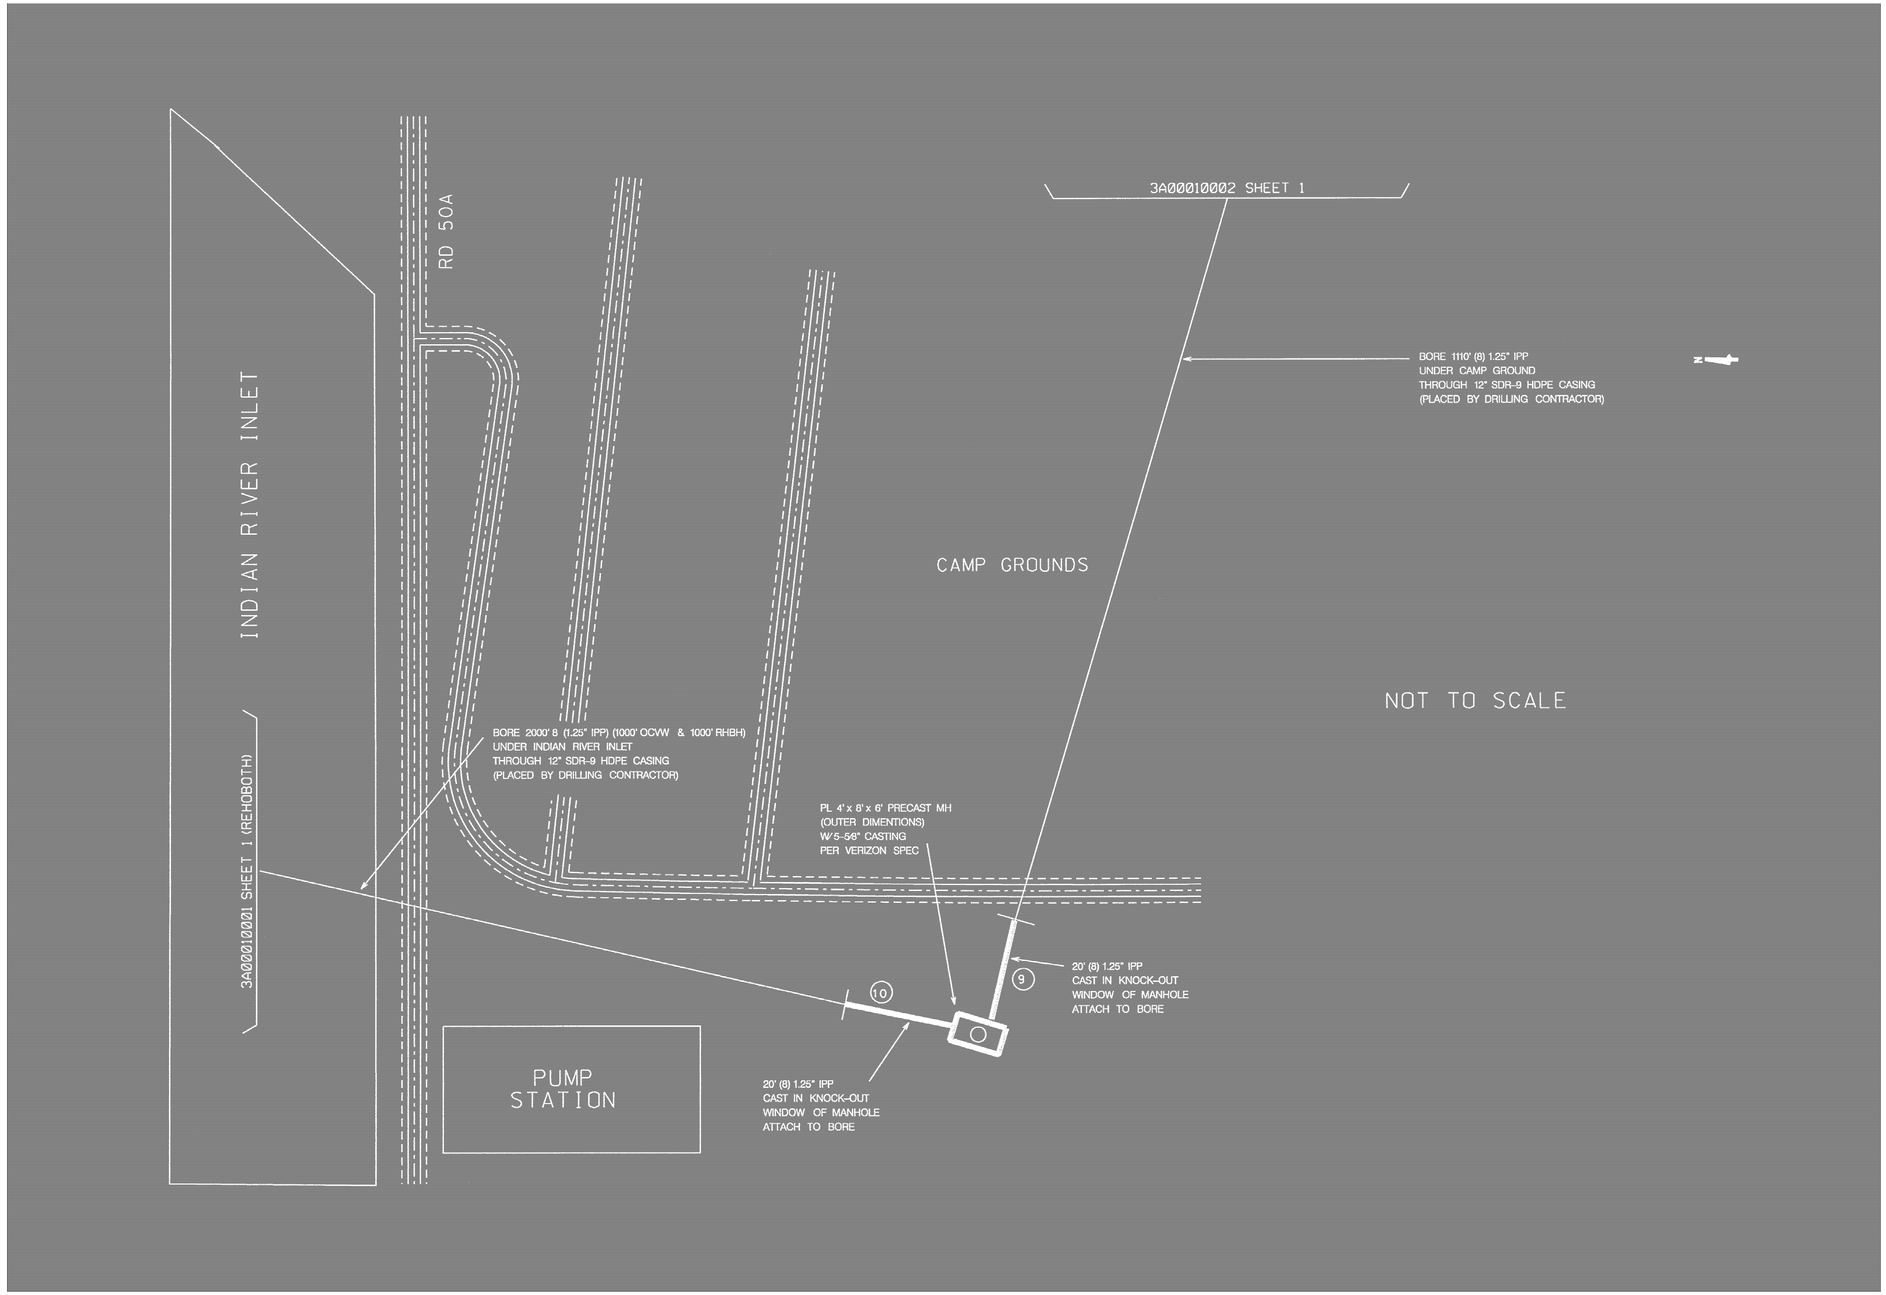

THIS PLAN DESGINED & DEVELOPED BY VERIZON

DATE: DESCRIPTION: BY:

DELAWARE SEASHORE STATE PARK
INDIAN RIVER MARINA RE-DEVELOPMENT
PHASE II - VERIZON PLANS

DELAWARE DEPARTMENT OF NATURAL RESOURCES AND ENVIRONMENTAL CONTROL

DESIGNED BY: RK&K

DRAWN BY: RK&K

BUILDING NO.: N/A

DATE: OCTOBER 28, 2004

SCALE: 1" = 50'

SHEET NO.: PLAN 05

E.F.N.:

k:\Projects\2003\IRB\DNREC\Dgn\Dnrec11V_IRB.dgn
9/21/2006
1:38:20 PM