NOTE:
1. THE LOCATION OF ALL UNDERGROUND UTILITIES AND FEATURES SHOWN ARE APPROXIMATE ONLY AND NO GUARANTEE IS MADE THAT ALL EXISTING UTILITIES ARE SHOWN ON THE PLAN. THE CONTRACTOR SHALL FIELD VERIFY BOTH HORIZONTAL AND VERTICAL LOCATIONS OF ALL EXISTING UTILITIES PRIOR TO BEGINNING ANY CONSTRUCTION AT NO ADDITIONAL COST. THE CONTRACTOR SHALL CONTACT MISS UTILITY (1-800-282-8555) PRIOR TO THE BEGINNING OF ANY CONSTRUCTION ACTIVITY.

HDD POINT
STA. 201+16.42
ELEV. -3.79

POT STA. 200+96.42

REMOVE ALIGNMENT WATER 4

REVISED ALIGNMENT

PROPOSED 16" HDPE WATER MAIN
SEE SHEET NO.- PROFILE 01

PROPOSED VERIZON (PHASE II)

GROUND INTERCEPT PT.
STA. 200+80.07.
ELEV. 1.99
N 219,349.5660
E 757,240.9469

STABILIZED CONSTR. ENTR.

REMOVE ALIGNMENT

PROPOSED SANITARY (PHASE II)

REMOVE JACK & BORE

EXIST. R/W

PROPOSED VERIZON (PHASE II)

REMOVE ALIGNMENT WATER 2

NEW DETAIL

MATCH LINE SEE PLAN 02

MATCH LINE SEE PLAN 04

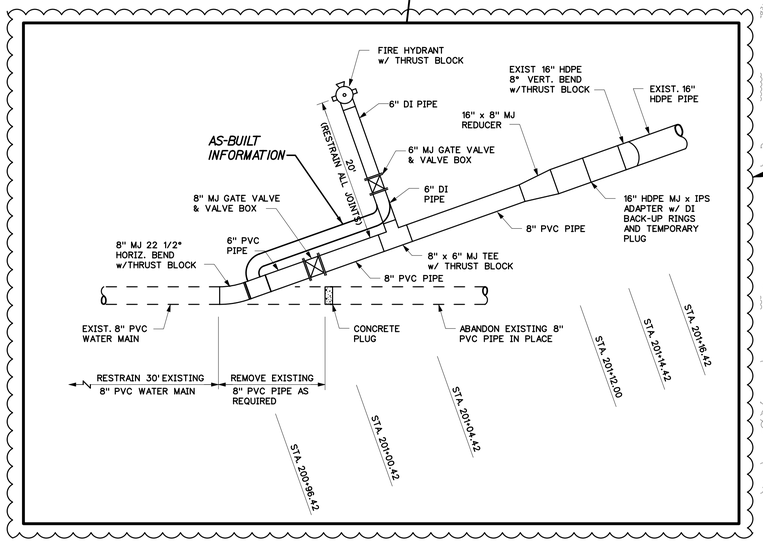

LEGEND

- STABILIZED CONSTRUCTION ENTRANCE
- PAVING PATCH
- —RSF— REINFORCED SILT FENCE
- —⊗— TEMPORARY CHAIN LINK FENCE
- -- UE -- PERMANENT EASEMENT

GRAPHIC SCALE
0 50 100

DATE:	DESCRIPTION:	BY:
1-25-05	1 REVISED ALIGNMENT AND DETAIL	RK&K
7-14-05	AS-BUILT INFORMATION	RK&K

DELAWARE SEASHORE STATE PARK
INDIAN RIVER MARINA RE-DEVELOPMENT
PHASE II – WATER MAIN

DELAWARE DEPARTMENT OF NATURAL RESOURCES AND ENVIRONMENTAL CONTROL

DESIGNED BY: RK&K
DRAWN BY: RK&K
BUILDING NO.: N/A
DATE: OCTOBER 15, 2004
SCALE: 1" = 50'
SHEET NO.: PLAN 01
E.F.N.:

PREPARED BY
THE CONSULTING FIRM OF
RUMMEL, KLEPPER & KAHL, LLP

DAVID WAYNE WALLACE REGISTERED No.6561

1.14.2005

9/21/2006
2:33:18 PM