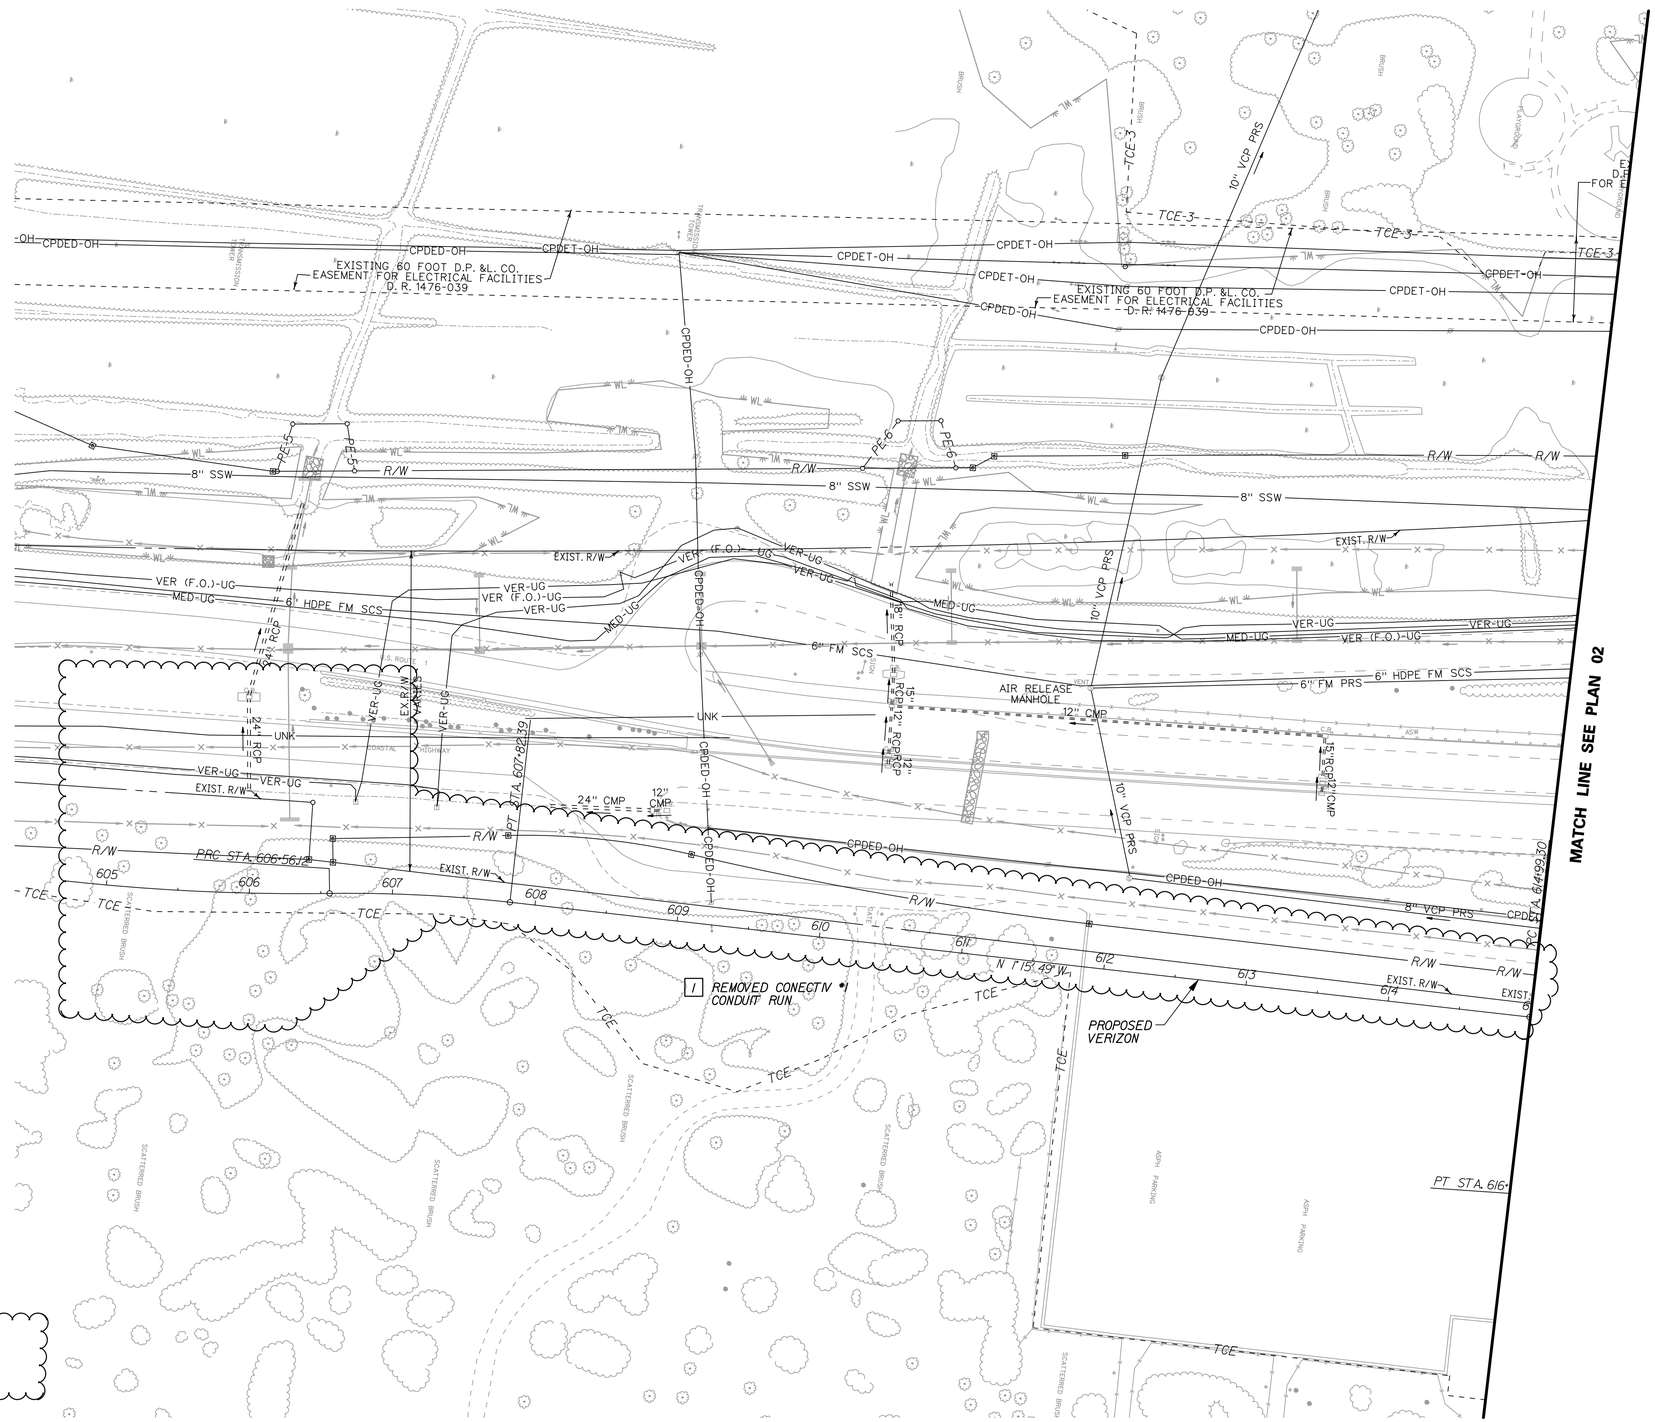


1 REMOVED NOTE

| DATE: | DESCRIPTION: | BY: |
|---|---|---|
| 3-16-05 | 1 REMOVED CONECTIV CONDUIT RUN | RK&K |

# DELAWARE SEASHORE STATE PARK
# INDIAN RIVER MARINA RE-DEVELOPMENT
## PHASE II – CONECTIV PLANS

DELAWARE DEPARTMENT OF NATURAL RESOURCES AND ENVIRONMENTAL CONTROL

DESIGNED BY: RK&K

DRAWN BY: RK&K

BUILDING NO.: N/A

DATE: FEBRUARY 11, 2005

SCALE: 1" = 50'

SHEET NO.: PLAN 01

E.F.N.:

k:\Projects\2003\IRB\DNREC\Dgn\dnrec03c_irb.dgn
9/21/2006
2:15:29 PM