CONTROL COORDINATES

	SANITARY (FORCE MAIN)	NORTH	EAST
1	POT 300+00.00	220,703.8046	755,784.2874
2	POT 300+52.81	220,686.2785	755,834.1011
3	POT 318+33.66	222,451.1128	756,072.3929
4	POT 320+05.83	222,588.0547	755,968.0323
	SANITARY (FORCE MAIN)	**NORTH**	**EAST**
1	POT 340+41.99	219,719.6578	757,247.0221
2	POT 340+71.02	219,718.5836	757,218.0097
3	POT 349+23.90	220,414.8327	756,725.4164
4	POT 354+09.83	220,899.5022	756,690.5395
	SANITARY (GRAVITY)	**NORTH**	**EAST**
1	POT 370+00.00	220,489.7213	756,688.7671
2	POT 374+20.58	220,909.4659	756,662.3239
3	POT 375+37.04	220,932.1831	756,776.5456
4	POT 379+32.82	221,269.2868	756,983.9258
5	POT 385+22.82	221,327.8286	757,571.0143
6	POT 386+45.96	221,233.1169	757,649.7121
7	POT 389+62.70	220,916.4538	757,656.6971
8	POT 390+13.21	220,915.3550	757,606.1996
9	POT 391+00.49	220,828.0940	757,608.0980

GENERAL NOTES:

1. CONTRACTOR TO PROVIDE TEMPORARY SUPPORTS FOR ALL UTILITIES.

2. THE LOCATION OF ALL UNDERGROUND UTILITIES AND FEATURES SHOWN ARE APPROXIMATE ONLY AND NO GUARANTEE IS MADE THAT ALL EXISTING UTILITIES ARE SHOWN ON THE PLAN. THE CONTRACTOR SHALL FIELD VERIFY BOTH HORIZONTAL AND VERTICAL LOCATIONS OF ALL EXISTING UTILITIES PRIOR TO BEGINNING ANY CONSTRUCTION AT NO ADDITIONAL COST. THE CONTRACTOR SHALL CONTACT MISS UTILITY (1-800-282-8555) PRIOR TO THE BEGINNING OF ANY CONSTRUCTION ACTIVITY.

3. DATUMS: VERTICALLY, THIS PROJECT REFERENCES NGVD 88 HORIZONTALLY, THIS PROJECT REFERENCES THE DELAWARE STATE COORDINATE SYSTEM FOR NAD 83/91.

AS-BUILT DRAWINGS

THE "AS-BUILTS" INFORMATION SHOWN ON THESE DRAWINGS ARE FROM FIELD SURVEY INFORMATION SUPPLIED BY DELDOT.

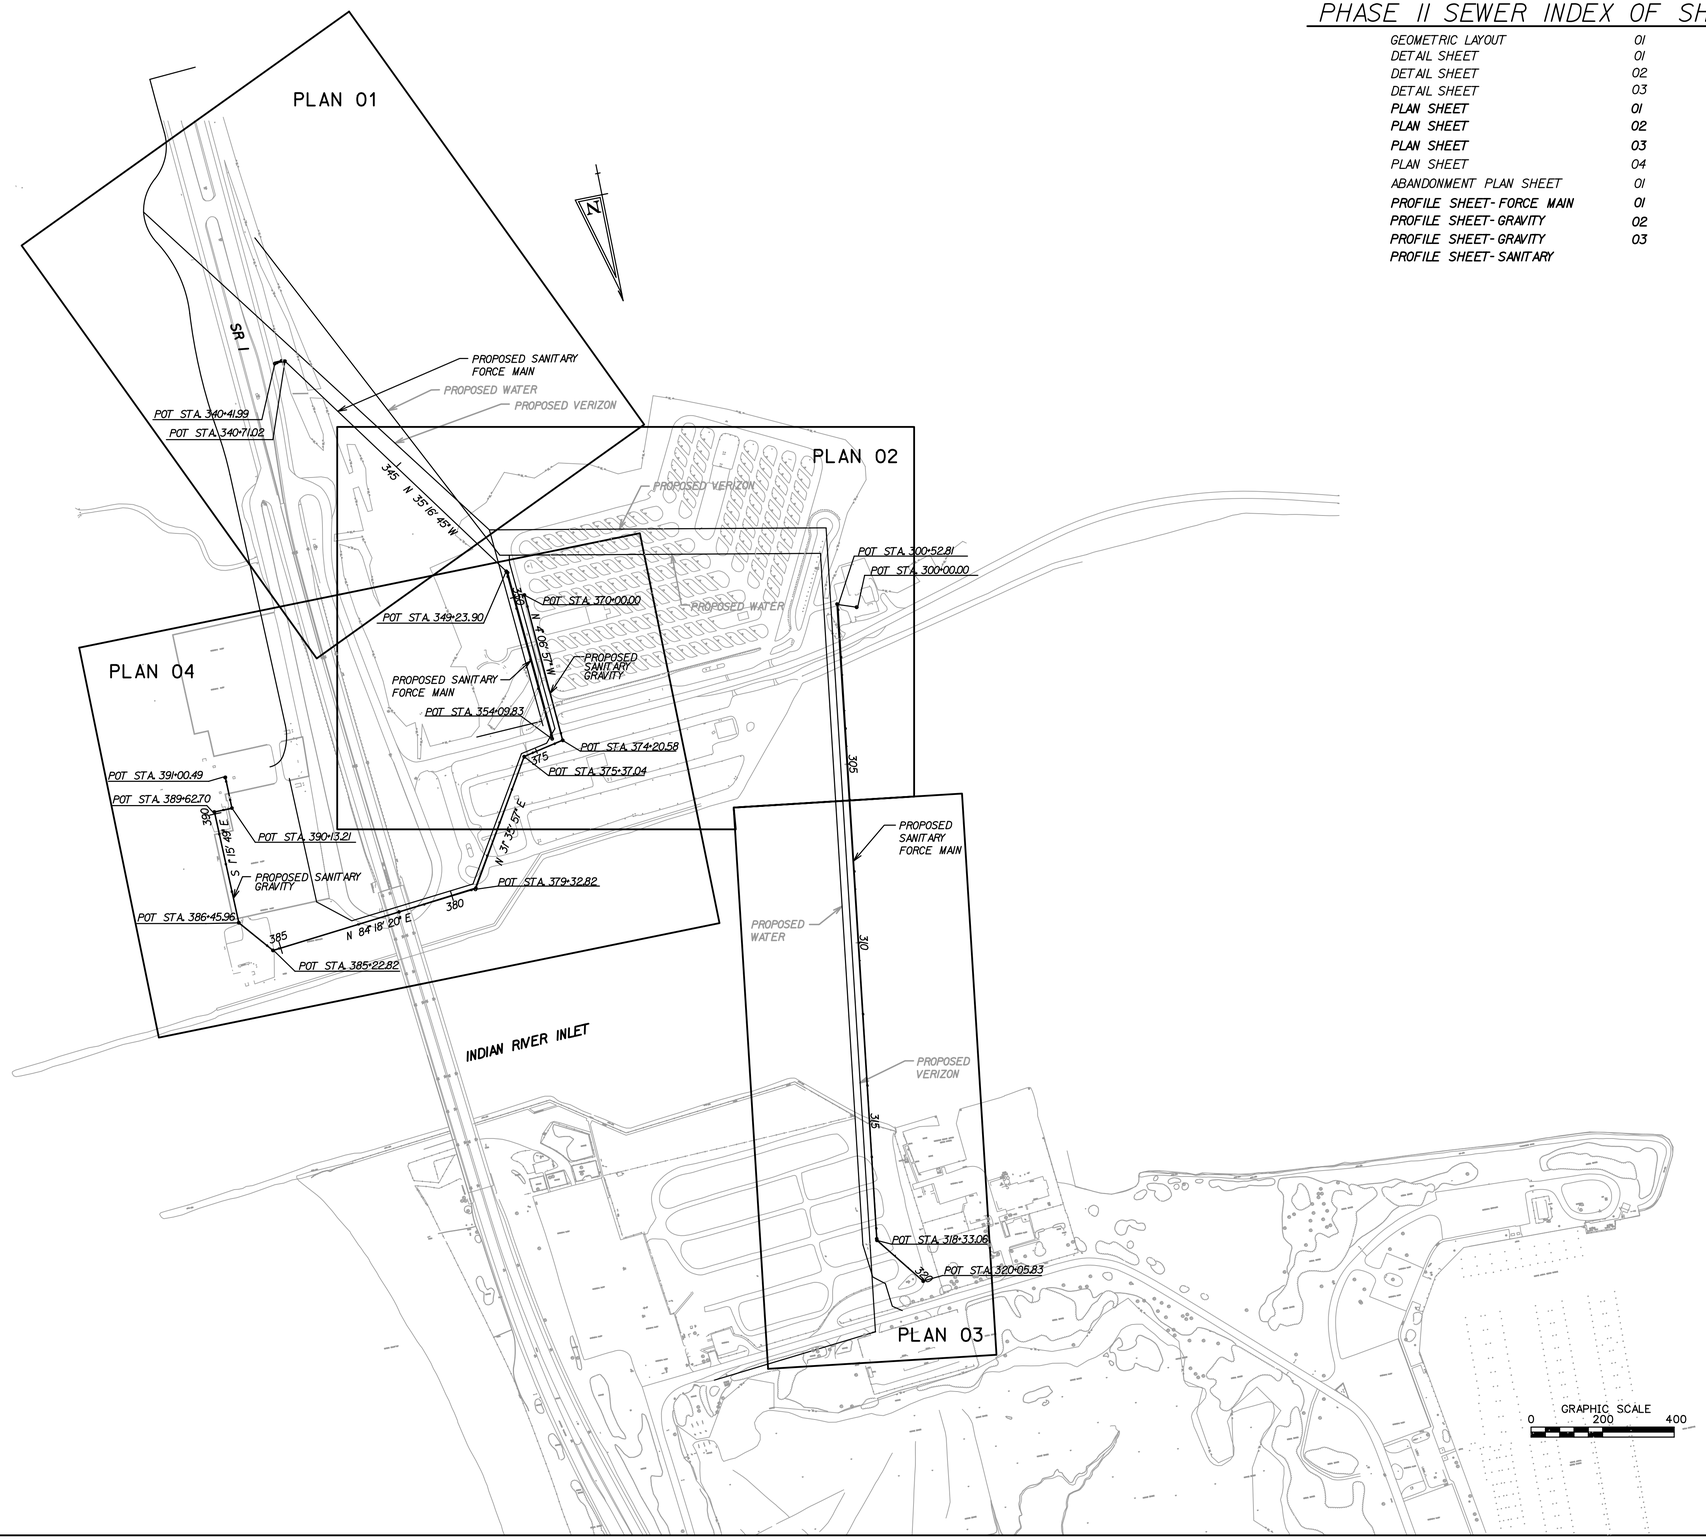

PHASE II SEWER INDEX OF SHEETS

GEOMETRIC LAYOUT	01
DETAIL SHEET	01
DETAIL SHEET	02
DETAIL SHEET	03
PLAN SHEET	01
PLAN SHEET	02
PLAN SHEET	03
PLAN SHEET	04
ABANDONMENT PLAN SHEET	01
PROFILE SHEET- FORCE MAIN	01
PROFILE SHEET- GRAVITY	02
PROFILE SHEET- GRAVITY	03
PROFILE SHEET- SANITARY	

DATE:	DESCRIPTION:	BY:
7-14-05	AS-BUILT INFORMATION	RK&K

DELAWARE SEASHORE STATE PARK
INDIAN RIVER MARINA RE-DEVELOPMENT
PHASE II SANITARY SEWER PLANS

DELAWARE DEPARTMENT OF NATURAL RESOURCES AND ENVIRONMENTAL CONTROL

DESIGNED BY: RK&K

DRAWN BY: RK&K

BUILDING NO.: N/A

DATE: OCTOBER 15, 2004

SCALE: 1" = 200'

SHEET NO.: GEOMETRIC LAYOUT 01

E.F.N.:

PREPARED BY
THE CONSULTING FIRM OF

RUMMEL, KLEPPER & KAHL, LLP
CONSULTING ENGINEERS
Baltimore, Maryland

DAVID WAYNE WALLACE REGISTERED No. 6561 DELAWARE PROFESSIONAL ENGINEER

SEAL

RECOMMENDED

10.15.2004
DATE

k:\Projects\2003\IRB\DNREC\Dgn\DNREC01B_IRB.DGN
9/21/2006
1:54:11 PM