SANITARY SEWER PROFILE
8" AND 10" PVC GRAVITY SEWER

SCALE
0 50 100 HORIZ.
0 5 10 VERT.

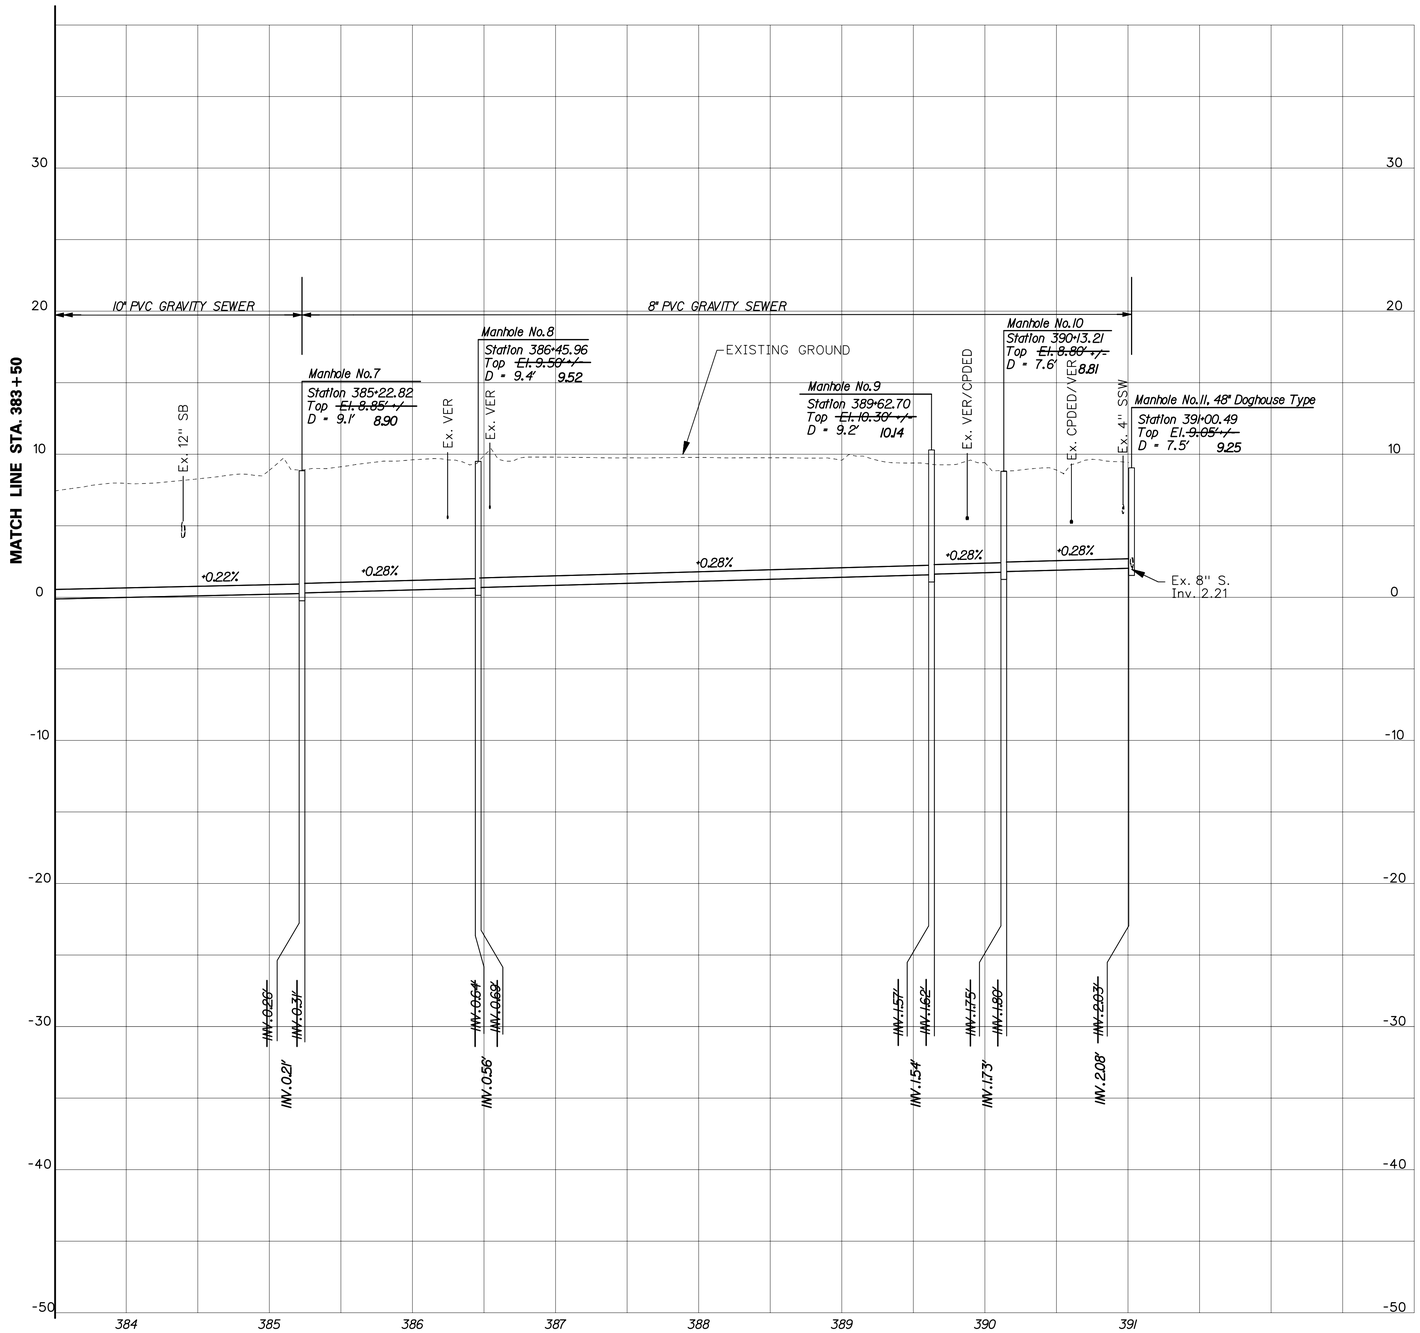

DATE:	DESCRIPTION:	BY:
7-14-05	AS-BUILT INFORMATION	RK&K

DELAWARE SEASHORE STATE PARK
INDIAN RIVER MARINA RE-DEVELOPMENT
PHASE II SANITARY SEWER PLANS

DELAWARE DEPARTMENT OF NATURAL RESOURCES AND ENVIRONMENTAL CONTROL

DESIGNED BY: RK&K
DRAWN BY: RK&K
BUILDING NO.: N/A
DATE: OCTOBER 15, 2004
SCALE: 1" = 50'
SHEET NO.: PROFILE 03
E.F.N.:

k:\Projects\2003\IRB\DNREC\Dgn\DNREC12B_IRB.DGN
9/21/2006
2:11:49 PM