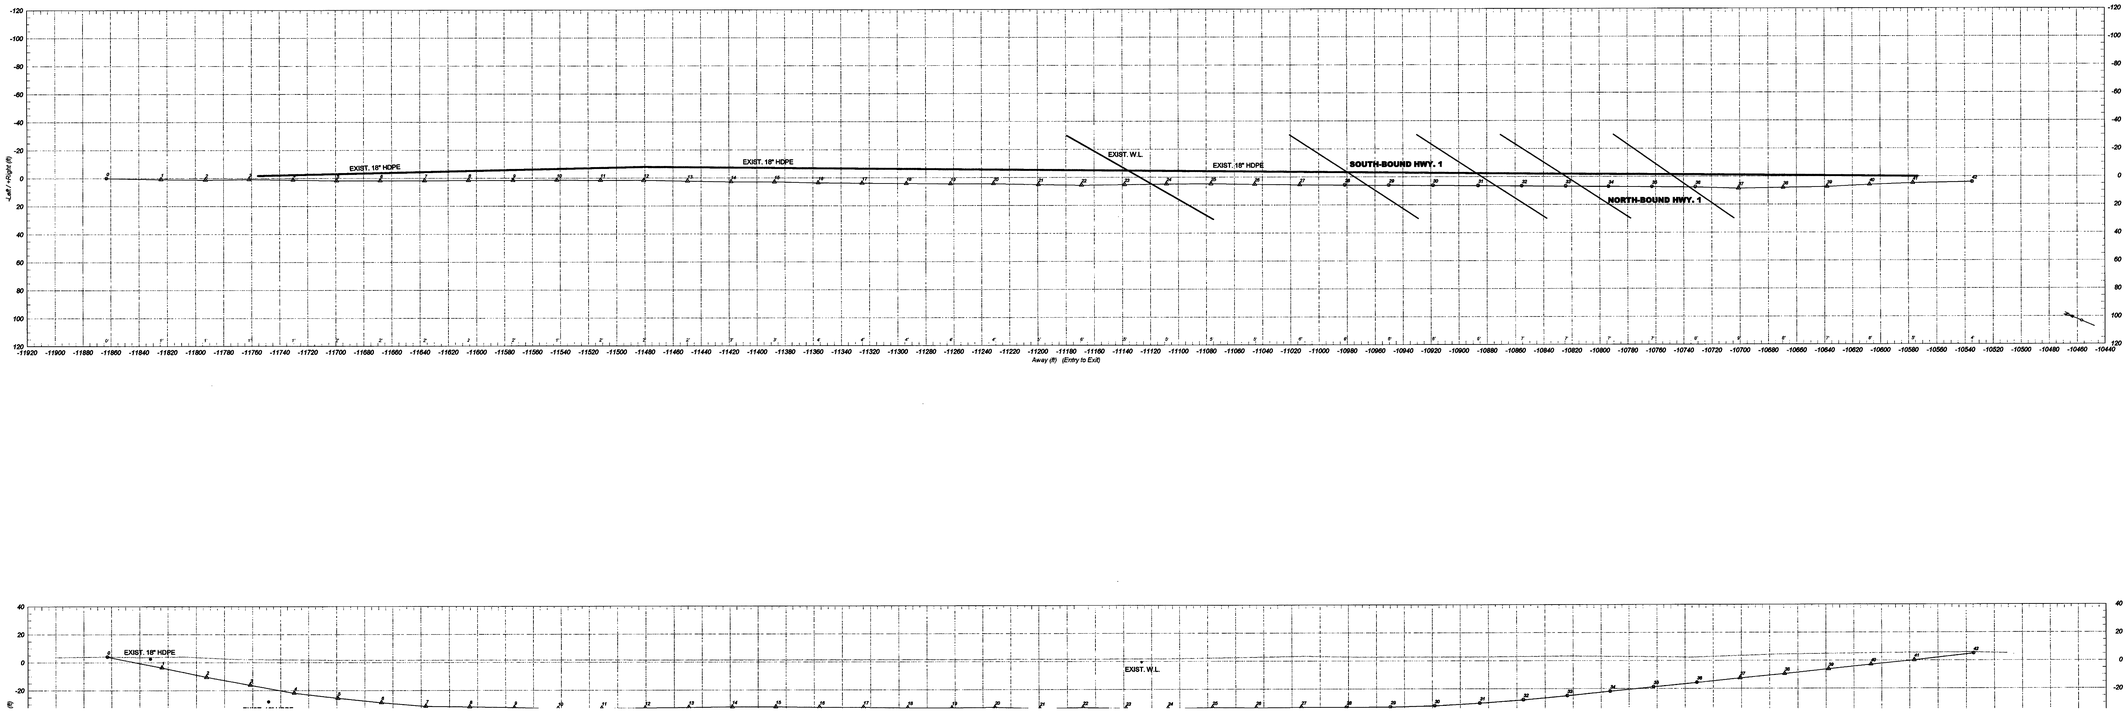
EXIST. 18" HDPE
EXIST. 18" HDPE
EXIST. W.L.
EXIST. 18" HDPE
SOUTH-BOUND HWY. 1
NORTH-BOUND HWY. 1
Left / - Right (ft)
Away (ft) (Entry to Exit)
EXIST. 18" HDPE
EXIST. W.L.